
CALL BLUESTAKES @ 811 AT LEAST 48 HOURS PRIOR TO THE COMMENCEMENT OF ANY Know what's below.
Call before you dig.

CENTERLINE MONUMENT
9TH ST & WALL AVE
(FOUND OGDEN CENTERLINE MONUMENT)

BENCHMARK CENTERLINE MONUMENT FOUND AT INTERSECTION OF 9TH STREET AND GRANT ELEV = 4291.61'

12-090-0030 12-090-0041 12-090-0043 12-090-0031 12-090-0036 12-090-0035 12-090-0032 12-090-0034 12-090-0033 ZNOC ENTERPRISES LLC TAMARA ADAMS DAVID MORONI MCNEW KANYA ZARFL JOE M & **GARY & MICHELLE** MERRILL D & AMANDA KERRY HANGOCK VELAINA SINGLETON JEANNETTE OWENS ORTEGON SHERWIN eranis estats tatata tatata estats estats the expensive represents represent represent represent representation expensive 12-090-0028 S RALPH MI EGGLESTON S 89°09'53" E 66.00' S 89°10'26" E 388.93' 12-089-0046 KRISTIN LYNN HEULITT LIVING TRUST course excess commo constru contra contra contra contra contra contra contra con SURVEYED PARCEL 103,198 sq.ft. 2.369 acres ومورة ومورة ومرونة ومرو N 89°10'53" W 122.33' 12-089-0043 ANDERSON FAMILY REVOCABLE TRUST 12-089-0042 SCOTT K ROSE come come come come come come come acces acces and any N 89°09'16" W 332.59' 12-089-0034 12-089-0037 12-089-0033 12-089-0040 12-089-0039 12-089-0038 12-089-0036 12-089-0035 CHRISTINA & HAROLD H KOGA FAMILY I REDLINE THOMAS & CINDY OSCAR ESPINOZA JAIME DUARTE BART W WALLACE FERN C FRYE MATTHEW HARDING PROPERTIES LLC LANSERT TRUST 9TH STREET (PUBLIC STREET)

BASIS OF BEARINGS N 89°09'45" W 1525.91' (RECORD)1525.91' (MEASURED)

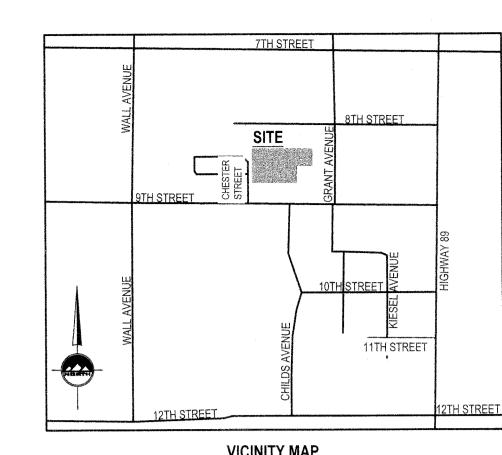

VICINITY MAP NOT TO SCALE OGDEN, WEBER COUNTY, UTAH


LEGEND SECTION CORNER ADJACENT RIGHT OF WAY RIGHT OF WAY MONUMENT ENSIGN ENG. EXIST REBAR AND CAP ____ CENTERLINE LAND SURV. SET ENSIGN REBAR AND CAF PROPERTY LINE ADJACENT PROPERTY LINE WATER METER ---- DEED LINE WATER VALVE ————— TANGENT LINE FIRE HYDRANT EXIST DITCH FLOW LINE SECONDARY WATER VALVE EENCE IRRIGATION VALVE EDGE OF ASPHALT SANITARY SEWER MANHOLE SS SANITARY SEWER LINE SD STORM DRAIN LINE (D) STORM DRAIN CLEAN OUT LAND DRAIN LINE STORM DRAIN CATCH BASIN STORM DRAIN COMBO BOX ----- W ----- CULINARY WATER LINE STORM DRAIN CULVERT SW SECONDARY WATER LINE --- SIGN IRR IRRIGATION LINE OHP OVERHEAD POWER LINE (E) ELECTRICAL BOX CO UTILITY POLE GAS LINE EXISTING CONTOURS ⇔ LIGHT CONCRETE CABLE BOX BUILDING TELEPHONE BOX PUBLIC DRAINAGE EASEMENT GAS METER DENSE VEGETATION PREVENTING ACCESS FOR ACCURATE SURVEY // TREE

CENTERLINE MONUMENT 9TH ST & GRANT AVE

(FOUND OGDEN CENTERLINE MONUMENT)

NOTE: MAY CONTAIN SYMBOLS THAT ARE NOT USED IN THIS PLAN SET.

HORIZONTAL GRAPHIC SCALE

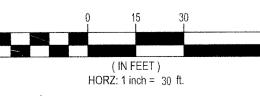

LOCATED IN THE SOUTHEAST QUARTER OF SECTION 17 TOWNSHIP 6 NORTH, RANGE 1 WEST SALT LAKE BASE AND MERIDIAN OGDEN CITY, WEBER COUNTY, UTAH

THE STANDARD IN ENGINEERING

LAYTON 919 North 400 West Layton, UT 84041 Phone: 801.547.1100

SANDY

Phone: 801.255.0529 **TOOELE** Phone: 435.843.3590 **CEDAR CITY**

Phone: 435.865.1453 RICHFIELD Phone: 435.896.2983

WWW.ENSIGNENG.COM

HIGH DESERT DESIGNS, GARY CANNON 9067 S 1300 W SUITE 203 WEST JORDAN, UTAH 84088

CONTACT GARY CANNON PHONE: 801-573-8282

STREE K CHESTE

STREET

STER


218 CHES OGDEN,


ALTA/NSPS LAND TITLE SURVEY

PRINT DATE 2024-12-30 PROJECT MANAGER
T. WILLIAMS




BENCHMARK CENTERLINE MONUMENT FOUND AT INTERSECTION OF 9TH STREET AND GRANT ELEV = 4291.61'

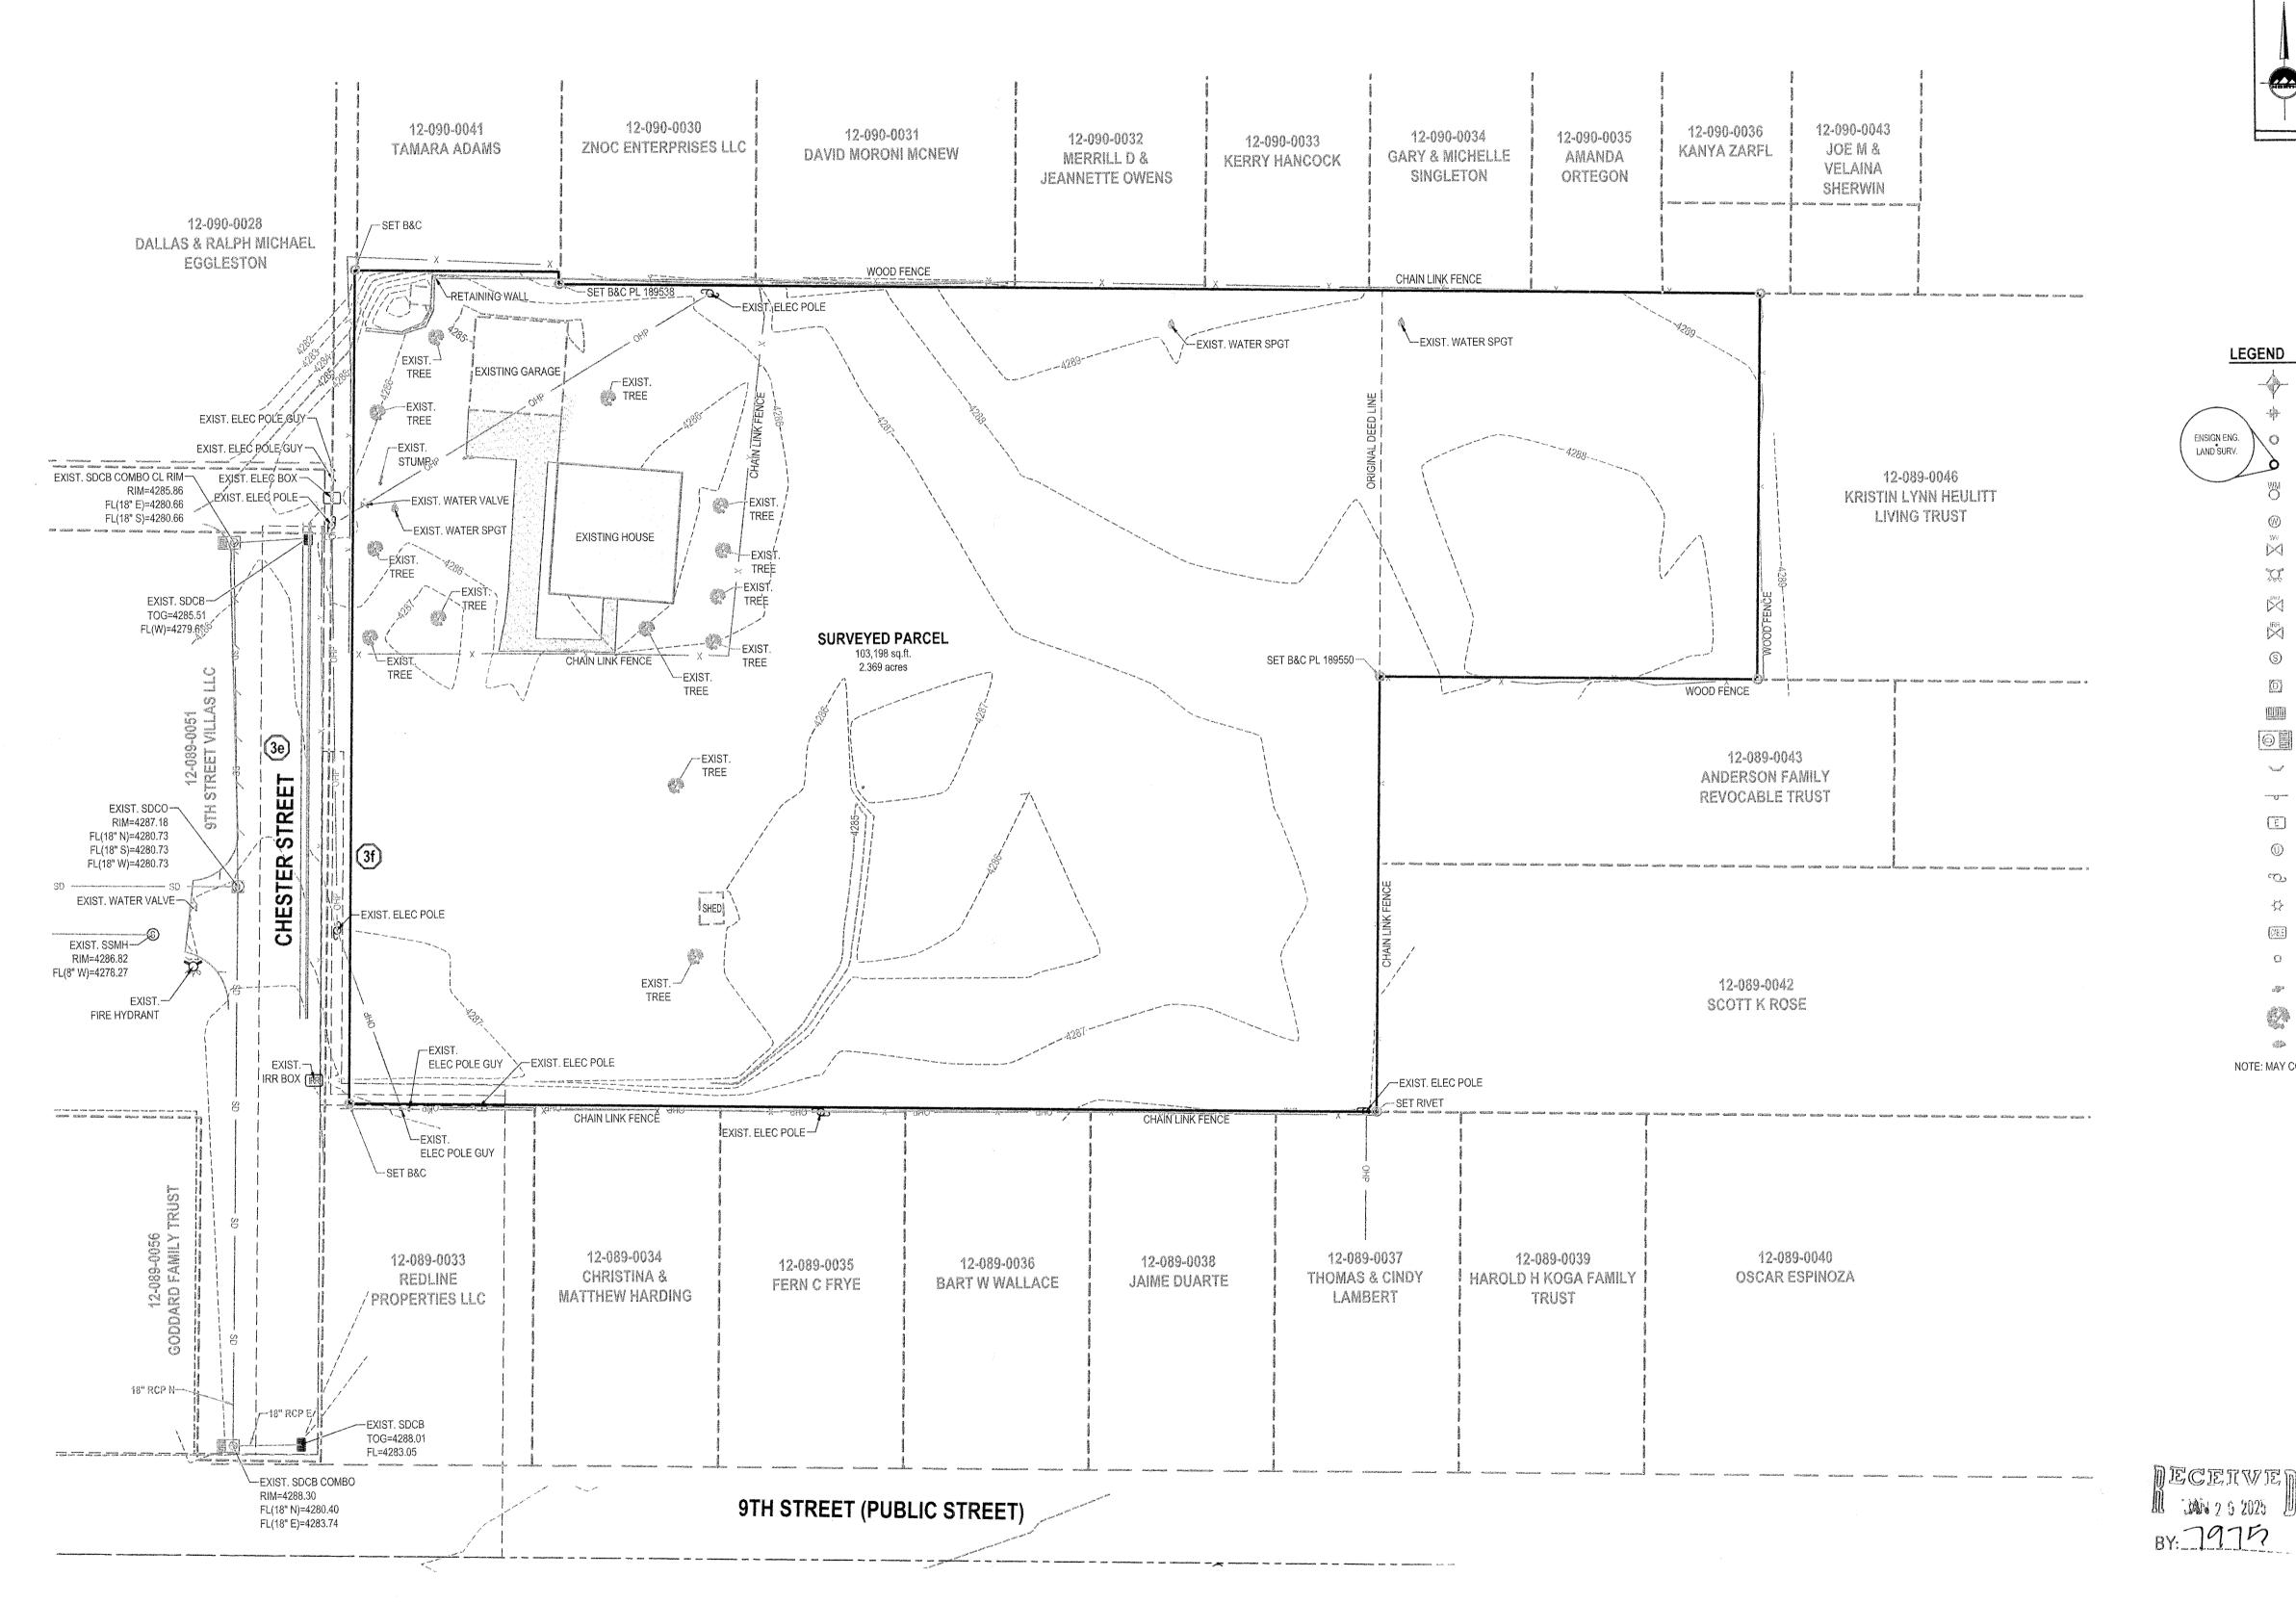

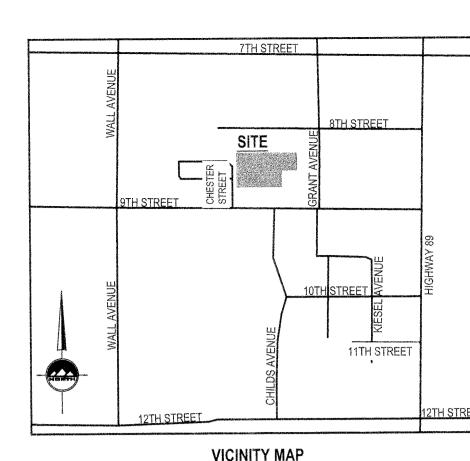

VICINITY MAP NOT TO SCALE OGDEN, WEBER COUNTY, UTAH

LEGEND

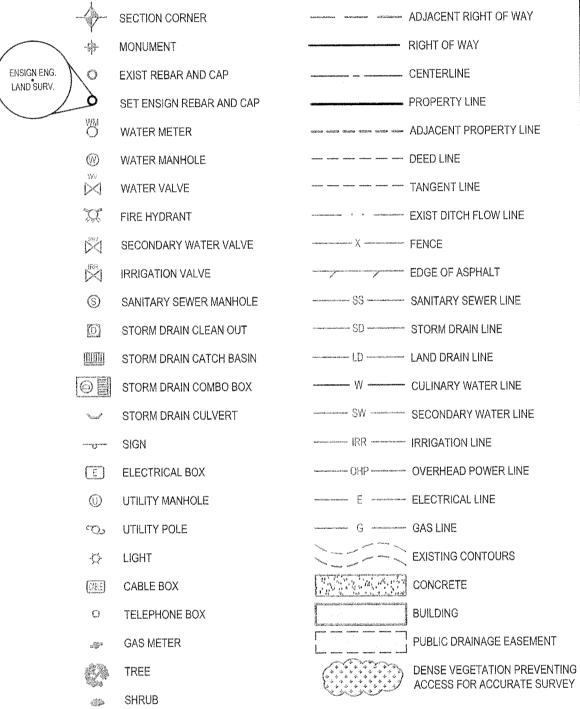

NOTE: MAY CONTAIN SYMBOLS THAT ARE NOT USED IN THIS PLAN SET.

HORIZONTAL GRAPHIC SCALE

LOCATED IN THE SOUTHEAST QUARTER OF SECTION 17 TOWNSHIP 6 NORTH, RANGE 1 WEST SALT LAKE BASE AND MERIDIAN OGDEN CITY, WEBER COUNTY, UTAH

HORZ: 1 inch = 30 ft.



919 North 400 West Layton, UT 84041 Phone: 801.547.1100

Phone: 801.255.0529

Phone: 435.843.3590

Phone: 435.896.2983

HIGH DESERT DESIGNS, GARY CANNON

9067 S 1300 W SUITE 203

PHONE: 801-573-8282

CONTACT:

TREE

ER

CHEST

ALTA/NSPS

LAND TITLE

PROJECT NUMBER

PROJECT MANAGER T. WILLIAMS

PRINT DATE 2024-12-30

DESIGNED BY J. DAVIS

2 of 3

SURVEY

STER STREET N, UTAH 84404

218 CHES OGDEN,

GARY CANNON

WEST JORDAN, UTAH 84088

WWW.ENSIGNENG.COM

CEDAR CITY Phone: 435.865.1453

RICHFIELD

SANDY

TOOELE

SURVEYOR'S CERTIFICATE

I, Trent R. Williams, do hereby represent that I am a Registered land Surveyor and that I hold Certificate No. 8034679 as prescribed by the laws of the State of Utah and I have made a survey of the following described property, and that it is true and correct based on record information obtained from research and comparing it with survey data collected in the field.

"To: Gary Cannon, US Title Insurance Agency

This is to certify that this map or plat and the survey on which it is based were made in accordance with the 2032 Minimum Standard Detail Requirements for ALTA/NSPS Land Title Surveys, jointly established and adopted by ALTA and NSPS, and includes Items: 1, 2, 3, 4, 6(a)(b), 7(a)(b1)(b2)(c), 8, 9, 11(a)(b), 12, 13, 14, 16, 17 and 18 of Table A thereof. The field work was completed on 04/10/24.

Date of Plat or Map: AN 6, 2025



Trent R. Williams, PLS License no. 8034679

RECORD DESCRIPTION

Parcel 1: 12-089-0048

Part of the Southeast Quarter of Section 17, Township 6 North, Range 1 West, Salt Lake Meridian, U.S. Survey: Beginning at a point North 89°10'45" West 1780.06 feet and North 0°50'15" East 145.20 feet from the Southeast corner of said Quarter Section, and running thence North 0°50'15" East 264 feet; thence North 89°10'45" West 266.60 feet; thence North 0°50'15" East 4.08 feet; thence North 89°10'45" West 66 feet; thence South 0°50'15" West 268.08 feet; thence South 89°10'45" East 332.6 feet to the place of beginning.

Together with an easement for the purpose of laying and maintaining an underground sewer line from Ninth Street North a distance of 298.32 feet, as created by instrument recorded June 10, 1957 as Entry No. 276365 in Book 549 at Page 409 of Official Records.

Parcel 2: 12-089-0047

Part of the Southeast Quarter of Section 17, Township 6 North, Range 1 West, Salt Lake Meridian, U.S. Survey: Beginning at a point North 89°10'45" West 142.90 feet from a point on the West line of Grant Avenue, which is North 89°10' 45" West 1513.16 feet and North 0°50' East 285.20 feet from the Southeast corner of said Section 17, and running thence North parallel with Grant Avenue 124 feet; thence North 89°10'45" West 124 feet; thence South 0°50'15" West parallel to Grant Avenue 124 feet; thence South 89°10'45" East 124 feet to the place of beginning.

AS-SURVEYED DESCRIPTION

A parcel of land, situate in the Southeast Quarter of Section 17, Township 6 North, Range 1 West, Salt Lake Base and Meridian, said parcel also located in Ogden City, Weber County, Utah. Being more particularly described as follows:

Beginning at a point which is North 89°09'45" West 612.71 feet along the center line of 9th Street and North 00°50'27" East 145.48 feet from the found Ogden City Survey Monument at the intersection of 9th Street and Grant Ave and running thence:

North 00°50'07" East 267.80 feet;

thence South 89°09'53" East 66.00 feet;

thence South 0°50'07" West 3.94 feet;

thence South 89°10'26" East 388.93 feet along and beyond said southerly line to a point on an existing wood fence line and the westerly line of that parcel described in Entry No. 2958763.

thence South 00°50'08" West 123.95 feet along said westerly line to a point on an existing wood fence line and the northerly line of that parcel described in Entry No. 1605801;

thence North 89°10'53" West 122.33 feet along said northerly line;

thence South 00°50'23" West 140.00 feet along the westerly line of said parcel and beyond to a point on an existing chain link fence and the northerly line of that parcel described in Entry No. 3083815;

thence North 89°09'16" West 332.59 feet along said northerly line and beyond to the point of beginning.

Contains: 103,198 square feet or 2.369 acres.

NOTES:

1. For conditions of record not shown hereon as well as specific references to items in the title reports, please refer to a title report supplied by US Title Insurance Agency:

File Number: 068616

Commitment Date: July 10, 2023

2. Table A Items:

Item 1: Monuments have or will be places at each property corners.

Item 2: Address for the land described is Approx.:

218 Chester Street

Ogden, Utah 84404

Item 3: Flood Zone is designated as "X" per FEMA Map number 49057C0426F dated November 30, 2023.

Item 4: Gross land area is: 103,198 square feet or 2.369 acres.

Item 8: Substantial Features: At the time of the survey there was ongoing construction on the site to the West. Some utilities we inaccessible at the time.

Item 11(a)(b): Existing Utilities shown are taking from standard survey observation of the site. Utilities taken from others sources have been specifically noted hereon.

Item 13: Adjoining owners: Noted hereon.

Item 14: The nearest major street intersection is Wall and 9th Street approximately 3074 feet to the West. The intersection is in Ogden City.

Item 16: Based on a site visit dated 04/10/24 there was no visible evidence of earthwork nsite.

Item 17: There are no known changes to road rights-of-way adjacent to the subject parcel.

Item 18: Easements: Noted hereon as provided by the title report.

3. Schedule B: Exceptions from Coverage

a. Items 1-7 are general exceptions and cannot be plotted.

b. Item 8 refers to taxes and cannot be platted.

c. Item 9 refers to special service districts.

d. Item 10 refers to all existing roads, streets, alleys, ditches, reservoirs, utilities, canals, pipelines, power poles, telephone, sewer, gas or water lines and rights-of-way and easements thereof.

e. Item 11 refers a sewer easement in favor of Ralph L. Schlutter and Marble M. Schlutter dated June 10, 1957 as Entry No. 276365, Book 549, Page 921 and is noted hereon.

f. Item 12 refers to an easement in favor of The Mountain States Telephone and Telegraph Company dated July 15, 1969 as Entry No. 523104, Book 921, Page 245 and is not plotted hereon.

g. Item 13 states that no Deed of Trust appears of record.

h. Item 14 refers to Well and Water Rights.

DECETWE 1 JAN 2 5 2025 BY: 1979 THE STANDARD IN ENGINEERING

LAYTON
919 North 400 West
Layton, UT 84041

Phone: 801.547.1100 **SANDY**

TOOELE

Phone: 801.255.0529

Phone: 435.843.3590

CEDAR CITY Phone: 435.865.1453

RICHFIELD

Phone: 435.896.2983

WWW.ENSIGNENG.COM

FOR: HIGH DESERT DESIGNS, GARY CANNON 9067 S 1300 W SUITE 203

CONTACT:
GARY CANNON
PHONE: 801-573-8282

WEST JORDAN, UTAH 84088

CHESTER STREET

STREET

UTAH

218 CHE OGDEN

ALTA/NSPS LAND TITLE SURVEY

12755 2024PROJECT MANAGER DESIGN
T. WILLIAMS J. DA

3 of 3