

TAXING UNIT: 5458

S.W. 1/4
SECTION 24 T.5N., R.1W., S.L.B & M.
UINTAH DISTRICT
SCALE 1" = 200'

99

PREFIX 07-09D

UINTAH HIGHLANDS WATER & SEWER
IMPROVEMENT DISTRICT

SEE P. 47

EASTWOOD
SUB. NO. 3

EASTWOOD REAL
ESTATE COMPANY,
INC.

362.2'


EASTWOOD REAL ESTATE CO.

~~U 481 A to K~~
~~242 to 246 USA~~
0010

212.22 AC ± NET

EASTWOOD
REAL
ESTATE
COMPANY,
INC., A.C.
234 USA
0003

Q = 5.77°19'15"E, 109.90'
Q = 11.66°15'16"E, 155.14'

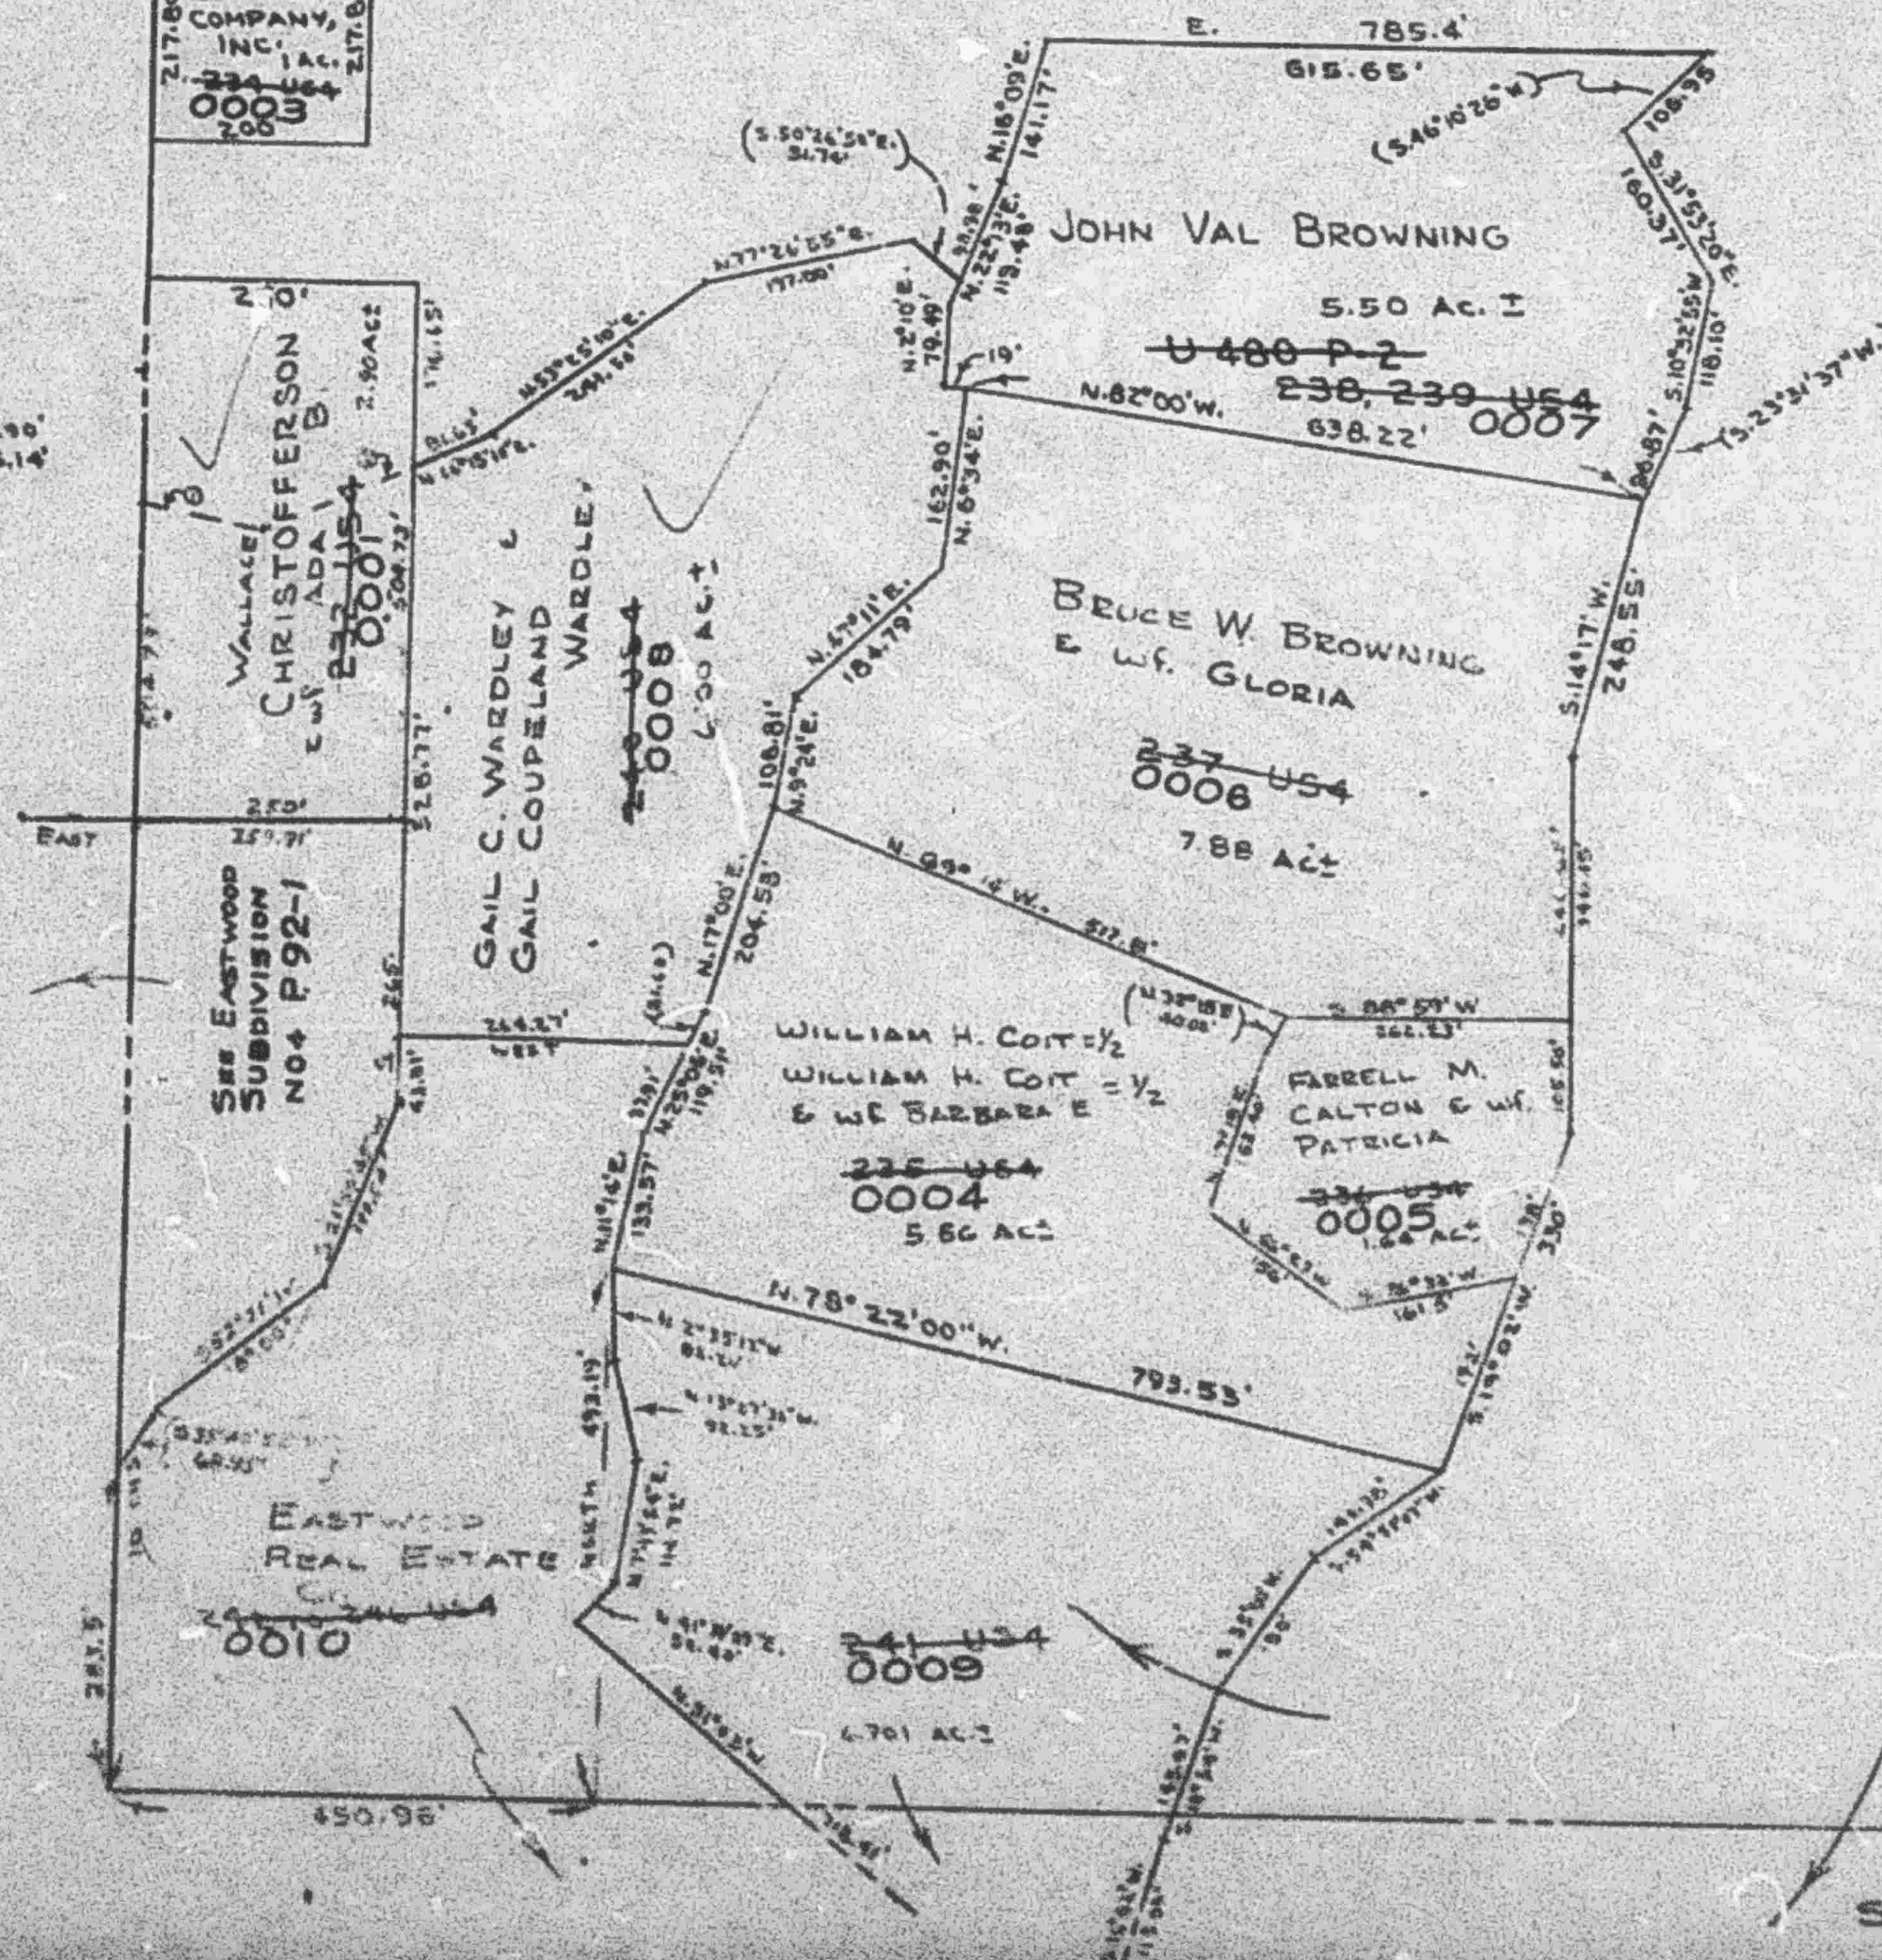

SEE PAGE 100