

PART OF N.W. 1/4 OF SEC. 14, T.5N., R.2W., S.L.B. & M.  
**DON-ITA SUBDIVISION NO. 4**

TAXING UNIT: 41

IN ROY CITY


PREFIX: 09-027

SCALE 1" = 40'

SEE P. ~~21~~<sup>29</sup>

SEE P. ~~25~~<sup>25</sup> BOOK ~~9~~<sup>9</sup>

SEE P. ~~26~~<sup>26</sup>

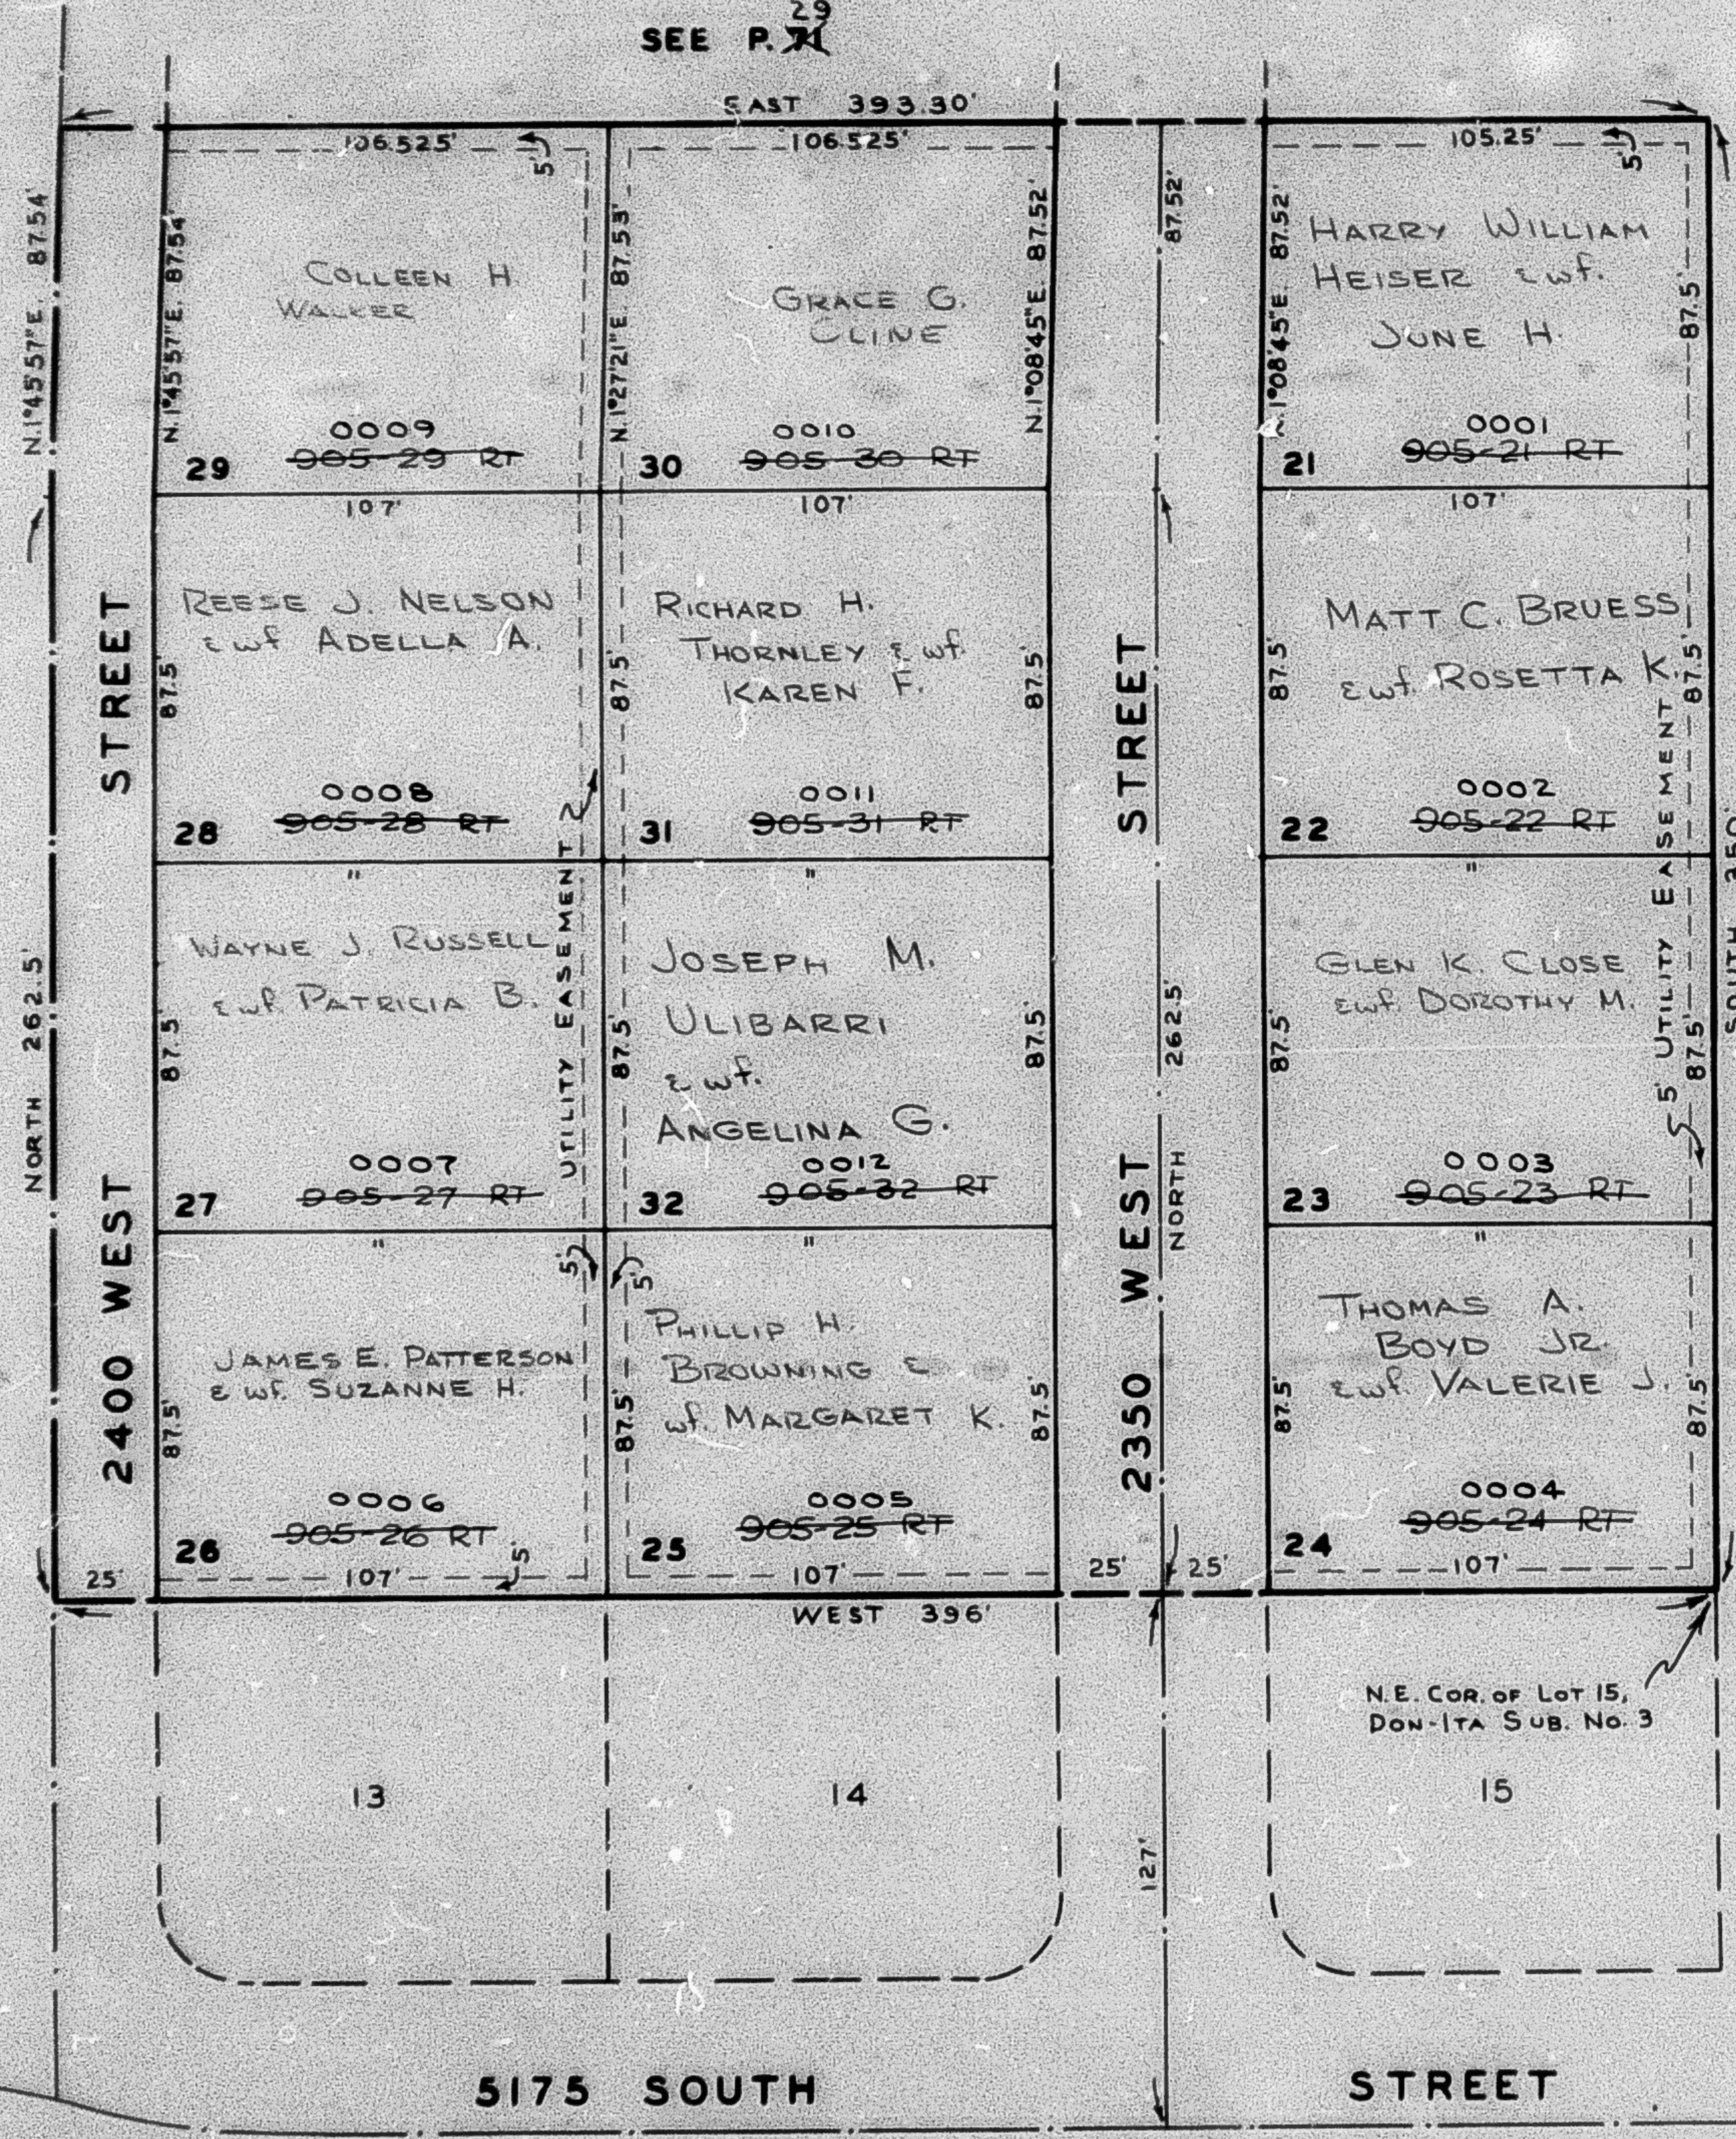

5175 SOUTH

STREET

SEE P. ~~26~~<sup>26</sup>